


SITE PLAN of Redi-Mix LLC

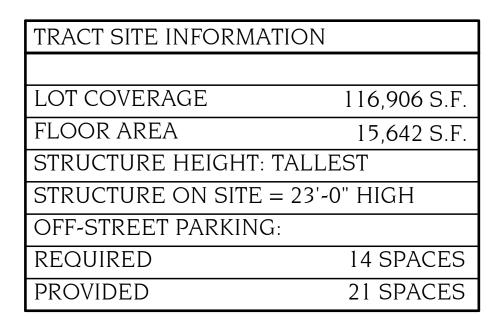

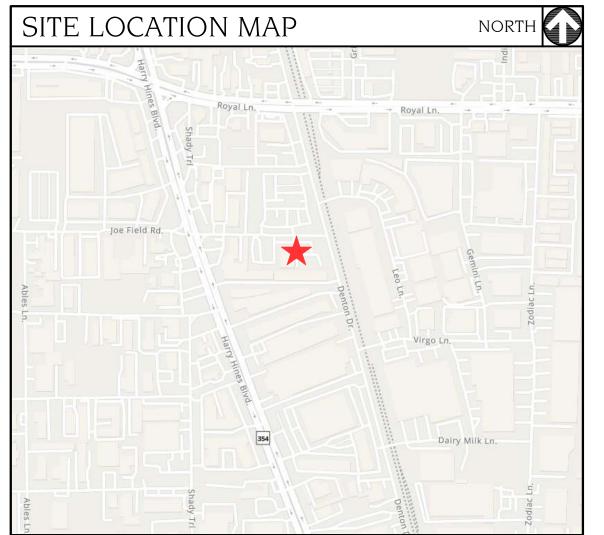

Need revised metes and bounds legal description approved by GIS for placement in ordinance. Property lines changed due to right-of-way dedication associated with Denton Drive improvements.)

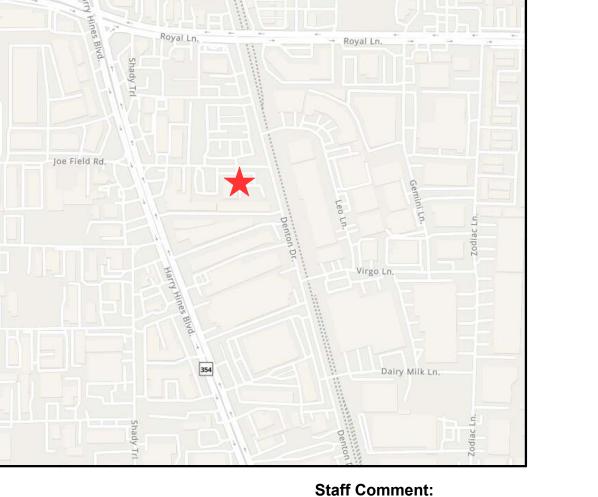

McCASLIN ASSOCIATES 6500 Greenville Avenue, Suite 180 Dallas, Texas 75206

(214) 520-2500 FAX: (214) 528-2001 www.mccaslinassociates.com

ARCHITECTURE

CONSTRUCTION

ESTIMATING

ISSUES/ REVISIONS

12/13/22 City of Dallas Review 05/09/23 City of Dallas Review Comment Revisions

JOB NO.: 2251

DRAWN: CAP

CHECK: SAM

SCALE: 1'' = 20'-0''

ZONING FILE NUMBER Z212-196 (JA)

