

MT EL PLA

CHECKED BY: DRAWN BY: FILENAME:

M - LARGE/MEDIUM MITIGATION TREE

m - SMALL MITIGATION TREE

SCALE 1" = 30'

PLAN - NORTH SHEET NUMBER:

L 0.01

208 North Market Street

Dallas, TX 75202

NORRIS DESIGN
Planning | Landscape Architecture | Branding

SHEET TITLE:

LANDSCAPE


PLAN - SOUTH

SHEET NUMBER:

L 0.02

FRANKFORD ROAD

0 15 30 60 SCALE 1" = 30'

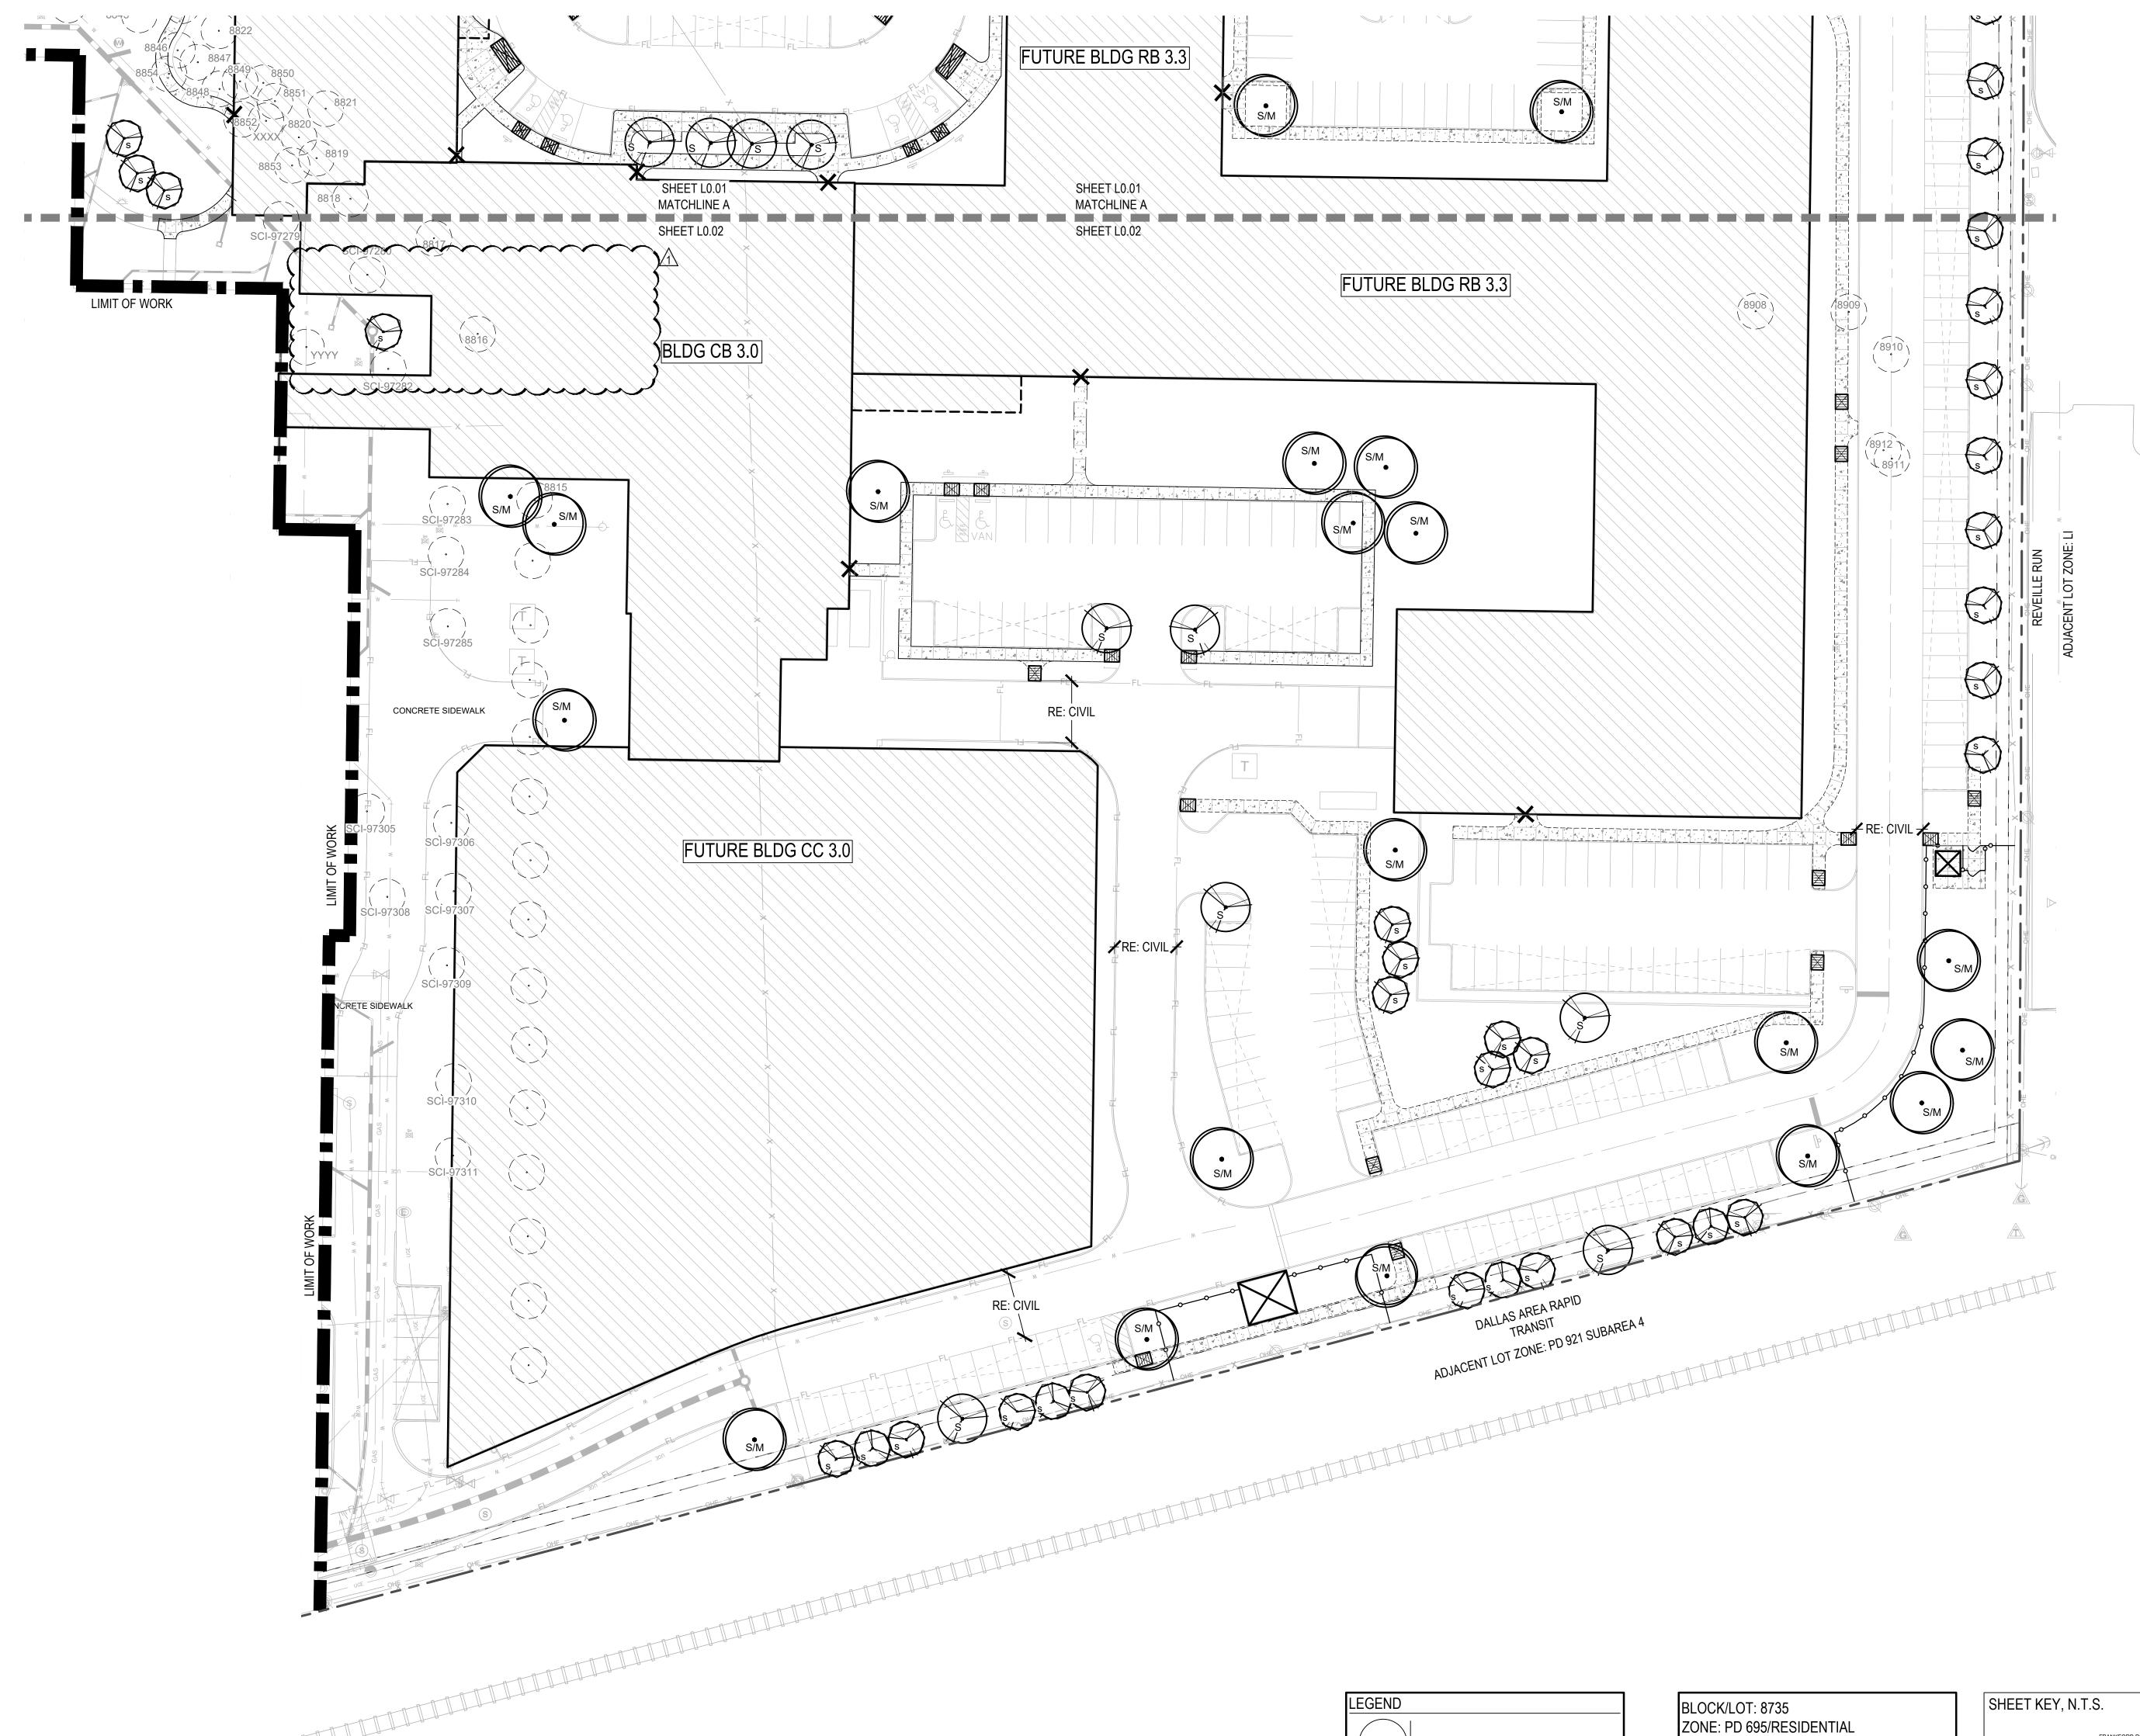

EXISTING TREE TO REMAIN

EXISTING TREE TO REMOVE

mmmm

★ BUILDING ENTRY

NOTE: REFER TO CIVIL FOR CONTOURS

AND ALL UNDERGROUND UTILITIES. ALL

ALL UNDERGROUND UTILITIES.

TREES SHALL BE LOCATED MIN. 5'-0" FROM

BOTANICAL NAME COMMON NAME

SPECIES VARIES LARGE TREE

PLANT LEGEND

SPECIES VARIES MEDIUM TREE

BOTANICAL NAME COMMON NAME

MT EL PLAI

CHECKED BY: DRAWN BY: FILENAME:

SPECIES VARIES SMALL TREE

NOTE: ALL TREES SELECTED FROM THE CITY OF DALLAS APPROVED TREE LIST AND MUST BE NATIVE OR ADAPTED SPECIES TO MEET L.I.D. STANDARDS OUTLINED IN DESIGN OPTIONS FOR ARTICLE X.

B - LARGE/MEDIUM BUFFER TREE b - SMALL BUFFER TREE

S - LARGE/MEDIUM SITE TREE s - SMALL SITE TREE

M - LARGE/MEDIUM MITIGATION TREE m - SMALL MITIGATION TREE

GENERAL NOTES

REQUIRED | PROVIDED

POSSIBLE SHOWN

40 PTS

- ALL LANDSCAPE AREAS WILL BE IRRIGATED WITH AN AUTOMATIC IRRIGATION SYSTEM. NO IRRIGATION LINE SHALL BE
- ALLOWED WITHIN THE DRIPLINE ON AN EXISTING TREE TREE PROTECTION FENCING MUST BE IN PLACE PRIOR TO THE CLEARING OF THE SITE OR ANY CONSTRUCTION AND MUST
- REMAIN UNTIL CONSTRUCTION IS COMPLETE. REFER TO CIVIL SHEETS FOR TREE PROTECTION FENCING LOCATIONS. EXISTING TREES SHALL BE MULCHED AT A DEPTH OF THREE INCHES AND A MINIMUM RADIUS OF 10 FEET FROM TREE BASE.
- CONTRACTOR TO PROVIDE AND INSTALL 6 INCHES OF APPROVED TOPSOIL TO ALL PLANTING AREAS. ALL DISTURBED AREAS SHALL BE REVEGETATED WITH A NATIVE GRASS MIX.
- PRUNE ALL EXISTING TREES TO ELIMINATE DEAD OR BROKEN LIMBS THAT MIGHT BE HAZARDOUS TO PEDESTRIANS. THE OWNER WILL CONTINUOUSLY MAINTAIN THE REQUIRED LANDSCAPING IN ACCORDANCE WITH CITY OF DALLAS CODES
- ADEQUATE BARRIERS BETWEEN ALL VEHICULAR USE AREAS AND ADJACENT LANDSCAPE AREAS. SUCH AS A 6" CONCRETE CURB ARE REQUIRED. IF A STANDARD 6" CURB AND GUTTER ARE NOT PROVIDED FOR ALL VEHICULAR USE AREAS AND ADJACENT LANDSCAPE AREAS. COMPLY WITH ECM. SECTION 2.4.7. "PROTECTION OF LANDSCAPE AREAS"
- THE NATIVE GRASS MIX 609S WILL BE PLANTED FOR SLOPE STABILIZATION. IF MORE RESTRICTIVE WATERING RESTRICTIONS ARE IN EFFECT WHEN LANDSCAPE PLANTING IS BEING CONSIDERED, CONTACT THE LANDSCAPE INSPECTOR (DETERMINE WHICH INSPECTOR APPLIES TO THE PARTICULAR PROJECT) BEFORE
- BEGINNING PLANTING. 10. THE IRRIGATION WILL COMPLY WITH DALLAS CITY CODE REGARDING THE CITY'S WATER CONSERVATION RESTRICTIONS.

SOIL CONDITIONING AND MULCHING NOTES

- A MINIMUM OF 3 INCHES OF ORGANIC MULCH SHALL BE ADDED IN NON-TURF AREAS TO THE SOIL SURFACE AFTER PLANTING. NON-POROUS MATERIAL SUCH AS SHEET PLASTIC SHALL NOT BE PLACED UNDER THE MULCH
- A MINIMUM OF 6" PERMEABLE SOIL, NATIVE OR IMPORTED, SHALL BE REQUIRED FOR TURF AND LANDSCAPED AREAS. THE ORGANIC MATTER CONTENT OF SUCH SOILS SHALL BE NOT LESS THAN 5% BY DRY WEIGHT
- TREE PLANTING AREAS TO BE PROVIDED WITH A MINIMUM OF 12 INCHES OF FRIABLE NATIVE LOAM SOIL (MAXIMUM 40% CLAY. MINIMUM 5% ORGANIC MATTER). PLANTING IN RELATIVELY UNDISTURBED EXISTING NATIVE SOILS IS ENCOURAGED. SOIL TO A MINIMUM DEPTH OF 12 INCHES IS REQUIRED WITHIN THE ENTIRE LANDSCAPE MEDIAN OR PENINSULA. ALL OTHER PLANTING AREAS MUST HAVE A MINIMUM SOIL DEPTH OF 12 INCHES WITH A RADIUS OF SIX FEET FROM THE TREE TRUNK. TREES ARE NOT TO BE PLANTED IN CALICHE, SOLID ROCK, OR, IN SOILS WHOSE TEXTURE HAS BEEN COMPACTED BY CONSTRUCTION EQUIPMENT, AREAS OF COMPACTION WHICH HAVE BEEN SUBSEQUENTLY AMENDED WITH 12 INCHES OF FRIABLE NATIVE SOIL ARE SUITABLE FOR PLANTING.

TREE PLANTING NOTES

- REMOVE NURSERY APPLIED TREE WRAP. TAPE OR STRING FROM TREE TRUNK AND CROWN. REMOVE ANY TAGS OR LABELS.
- PRUNE SUCKERS OFF SET ROOTBALL LEVEL TO GRADE OR SLIGHTLY ABOVE GRADE (1/2") IF IN CLAY SOIL.
- MULCH 3" DEEP LEAVING 3" CIRCLE OF BARE SOIL AROUND TRUNK OF TREE FOLD DOWN OR PULL BACK STRING, BURLAP OR PLASTIC EXPOSING ROOTBALL. REMOVE ALL NON-DEGRADABLE MATERIALS. DO NOT REMOVE SOIL FROM ROOTBALL
- BREAK UP SIDES OF PLANTING HOLE. CENTER ROOTBALL IN PLANTING HOLE. LEAVE BOTTOM OF PLANTING HOLE FIRM. DO NOT AMEND SOIL UNLESS PLANTING IN POOR OR SEVERELY DISTURBED SOIL OR BUILDING RUBBLE. USE WATER TO SETTLE SOIL AND REMOVE AIR POCKETS AND
- FIRMLY SET TREE. DO NOT STAKE UNLESS IN HEAVY CLAY SOIL, WINDY CONDITIONS, 3" OR GREATER DIAMETER TREE TRUNK OR LARGE CROWN. IF STAKING IS NEEDED DUE TO THESE CONDITIONS:
- a. STAKE WITH 2 x 2 HARDWOOD STAKES OR APPROVED EQUAL DRIVEN 6" 8" OUTSIDE OF ROOTBALL
- b. LOOSELY STAKE TREE TRUNK TO ALLOW FOR TRUNK FLEXING c. STAKE TREES JUST BELOW FIRS BRANCH WITH 2" - 3" WIDE BELT-LIKE, NYLON OR PLASTIC STRAPS (2 PER TREE ON
- OPPOSITE SIDES OF TREE. CONNECT FROM TREE TO STAKE HORIZONTALLY. DO NOT USE ROPE OR WIRE THROUGH A
- d. REMOVE ALL STAKING MATERIALS AFTER ONE YEAR

TREE PROTECTION NOTES

- ALL TREES AND NATURAL AREAS SHOWN ON PLAN TO BE PRESERVED SHALL BE PROTECTED DURING CONSTRUCTION WITH TEMPORARY FENCING
- 2. PROTECTIVE FENCES SHALL BE ERECTED ACCORDING TO CITY OF DALLAS STANDARDS FOR TREE PROTECTION
- PROTECTIVE FENCES SHALL BE INSTALLED PRIOR TO THE START OF ANY SITE PREPARATION WORK (CLEARING, GRUBBING OR GRADING). AND SHALL BE MAINTAINED THROUGHOUT ALL PHASES OF THE CONSTRUCTION PROJECT
- EROSION AND SEDIMENTATION CONTROL BARRIERS SHALL BE INSTALLED OR MAINTAINED IN A MANNER WHICH DOES NOT RESULT IN SOIL BUILD-UP WITHIN TREE DRIP LINES.
- 5. PROTECTIVE FENCES SHALL SURROUND THE TREES OR GROUP OF TREES. AND WILL BE LOCATED AT THE OUTERMOST LIMIT OF BRANCHES (DRIP LINE). FOR NATURAL AREAS, PROTECTIVE FENCES SHALL FOLLOW THE LIMIT OF CONSTRUCTION LINE. IN ORDER TO PREVENT THE FOLLOWING: a. SOIL COMPACTION IN THE ROOT ZONE AREA RESULTING FROM VEHICULAR TRAFFIC OR STORAGE OF EQUIPMENT OR
 - MATERIALS: b. ROOT ZONE DISTURBANCES DUE TO GRADE CHANGES (GREATER THAN 6 INCHES CUT OR FILL), OR TRENCHING NOT
- REVIEWED AND AUTHORIZED BY THE CITY ARBORIST
- c. WOUNDS TO EXPOSED ROOTS, TRUNK OR LIMBS BY MECHANICAL EQUIPMENT; d. $\,$ OTHER ACTIVITIES DETRIMENTAL TO TREES SUCH AS CHEMICAL STORAGE, CEMENT TRUCK CLEANING, AND FIRES.
- 6. EXCEPTIONS TO INSTALLING FENCES AT TREE DRIP LINES MAY BE PERMITTED IN THE FOLLOWING CASES: e. WHERE THERE IS TO BE AN APPROVED GRADE CHANGE, IMPERMEABLE PAVING SURFACE, TREE WELL, OR OTHER SUCH SITE DEVELOPMENT, ERECT THE FENCE APPROXIMATELY 2 TO 4 FEET BEYOND THE AREA DISTURBED;
- 3" MINIMUM DEPTH OF ORGANIC PRUNE ALL DEAD OR DAMAGED WOOD PRIOR TO PLANTING AMENDED SOIL IN PLANTING BED SET SHRUB ROOT-BALL 1" (2) PER SPECIFICATIONS. TILL SOIL HIGHER THAN FINISH BED TO A DEPTH OF EIGHT INCHES.
 - BROKEN OR CRUMBLING ROOT-BALLS WILL BE REJECTED 2. CARE SHOULD BE TAKEN NOT TO DAMAGE THE
 - ITS CONTAINER ALL JUNIPERS SHOULD BE PLANTED SO THE TOP OF THE ROOT-BALL OCCURS ABOVE THE FINISH
 - GRADE OF THE MULCH LAYER 4. DIG PLANT PIT TWICE AS WIDE AND HIGH AS THE CONTAINER

SHRUB OR ROOT-BALL WHEN REMOVING IT FROM

(3) FINISH GRADE (TOP OF MULCH)

- f. WHERE PERMEABLE PAVING IS TO BE INSTALLED WITHIN A TREE'S DRIP LINE, ERECT THE FENCE AT THE OUTER LIMITS OF THE PERMEABLE PAVING AREA (PRIOR TO SITE GRADING SO THAT THIS AREA IS GRADED SEPARATELY PRIOR TO PAVING INSTALLATION TO MINIMIZE ROOT DAMAGE):
- g. WHERE TREES ARE CLOSE TO PROPOSED BUILDINGS, ERECT THE FENCE TO ALLOW 6 TO 10 FEET OF WORK SPACE
- BETWEEN THE FENCE AND THE BUILDING: h. WHERE THERE ARE SEVERE SPACE CONSTRAINTS DUE TO TRACT SIZE, OR OTHER SPECIAL REQUIREMENTS, CONTACT
- THE CITY ARBORIST AT 214-948-4117 TO DISCUSS ALTERNATIVES.
- i. SPECIAL NOTE: FOR THE PROTECTION OF NATURAL AREAS, NO EXCEPTIONS TO INSTALLING FENCES AT THE LIMIT OF
- CONSTRUCTION LINE WILL BE PERMITTED WHERE ANY OF THE ABOVE EXCEPTIONS RESULT IN A FENCE BEING CLOSER THAN 4 FEET TO A TREE TRUNK, PROTECT THE
- TRUNK WITH STRAPPED-ON PLANING TO A HEIGHT OF 8 FT (OR TO THE LIMITS OF LOWER BRANCHING) IN ADDITION TO THE REDUCED FENCING PROVIDED.
- TREES APPROVED FOR REMOVAL SHALL BE REMOVED IN A MANNER WHICH DOES NOT IMPACT TREES TO BE PRESERVED ANY ROOTS EXPOSED BY CONSTRUCTION ACTIVITY SHALL BE PRUNED FLUSH WITH THE SOIL. BACKFILL ROOT AREAS WITH GOOD QUALITY TOP SOIL AS SOON AS POSSIBLE. IF EXPOSED ROOT AREAS ARE NOT BACKFILLED WITHIN 2 DAYS, COVER

THEM WITH ORGANIC MATERIAL IN A MANNER WHICH REDUCES SOIL TEMPERATURE AND MINIMIZES WATER LOSS DUE TO

- **EVAPORATION** 10. ANY TRENCHING REQUIRED FOR THE INSTALLATION OF LANDSCAPE IRRIGATION SHALL BE PLACED AS FAR FROM EXISTING
- NO LANDSCAPE TOPSOIL DRESSING GREATER THAN 4 INCHES SHALL BE PERMITTED WITHIN THE DRIP LINE OF TREES. NO SOIL IS PERMITTED ON THE ROOT FLARE OF ANY TREE.
- PRUNING TO PROVIDE CLEARANCE FOR STRUCTURES, VEHICULAR TRAFFIC AND EQUIPMENT SHALL TAKE PLACE BEFORE DAMAGE OCCURS (RIPPING OF BRANCHES, ETC.)
- ALL FINISHED PRUNING SHALL BE DONE ACCORDING TO RECOGNIZED, APPROVED STANDARDS OF THE INDUSTRY (REFERENCE THE NATIONAL ARBORIST ASSOCIATION PRUNING STANDARDS FOR SHADE TREES AVAILABLE ON REQUEST FROM THE CITY ARBORIST
- 14. DEVIATIONS FROM THE ABOVE NOTES MAY BE CONSIDERED ORDINANCE VIOLATIONS IF THERE IS SUBSTANTIAL NON-COMPLIANCE OR IF A TREE SUSTAINS DAMAGE AS A RESULT

SPECIAL CONSTRUCTION TECHNIQUES

- 1. PRIOR TO EXCAVATION WITHIN TREE DRIP LINES, OR THE REMOVAL OF TREES ADJACENT TO OTHER TREES THAT ARE TO REMAIN. MAKE A CLEAN CUT BETWEEN THE DISTURBED AND UNDISTURBED ROOT ZONES WITH A ROCK SAW OR SIMILAR EQUIPMENT TO MINIMIZE ROOT DAMAGE.
- IN CRITICAL ROOT ZONE AREAS THAT CANNOT BE PROTECTED DURING CONSTRUCTION WITH FENCING. AND WHERE HEAVY VEHICULAR TRAFFIC IS ANTICIPATED, COVER THOSE AREAS WITH FOUR (4) INCHES OF ORGANIC MULCH TO BE PRODUCED ON SITE. TO MINIMIZE SOIL COMPACTION
- PERFORM ALL GRADING WITHIN CRITICAL ROOT ZONE AREAS WITH SMALL EQUIPMENT TO MINIMIZE ROOT DAMAGE WATER ALL TREES MOST HEAVILY IMPACTED BY CONSTRUCTION ACTIVITIES DEEPLY AS NECESSARY DURING PERIODS O
- HOT, DRY WEATHER. SPRAY TREE CROWNS WITH WATER PERIODICALLY TO REDUCE DUST ACCUMULATION ON THE LEAVES 5. WHEN INSTALLING CONCRETE ADJACENT TO THE ROOT ZONE OF A TREE, US A PLASTIC VAPOR BARRIER BEHIND THE CONCRETE TO PROHIBIT LEACHING OF LIME INTO THE SOIL.

REMEDIAL TREE CARE NOTES AERATION AND SUPPLEMENTAL

NUTRIENT REQUIREMENTS FOR TREES WITHIN CONSTRUCTION AREAS


- TREES WILL BE FERTILIZED PRIOR TO ANY CONSTRUCTION ACTIVITY. MATERIALS AND METHODS ARE TO BE APPROVED BY THE CITY ARBORIST (214-948-4117) PRIOR TO APPLICATION.
- THE GENERAL CONTRACTOR SHALL SELECT A FERTILIZATION CONTRACTOR AND INSURE COORDINATION WITH THE CITY ARBORIST. WITHIN 7 DAYS AFTER FERTILIZATION IS PERFORMED, THE CONTRACTOR SHALL PROVIDE DOCUMENTATION OF THE WORK PERFORMED TO THE CITY ARBORIST
- ALL CLASS 1 TREES WITHIN (OR ADJACENT TO) THE LIMITS OF CONSTRUCTION WHICH ARE INDICATED TO BE PRESERVED (ON THE PLANS) WILL BE FERTILIZED PRIOR TO THE BEGINNING OF CONSTRUCTION ACTIVITIES AND AGAIN AFTER THE COMPLETION OF ALL CONSTRUCTION. AREAS TO BE FERTILIZED INCLUDE THE ENTIRE CRITICAL ROOT ZONE OF A TREE AS DEPICTED ON THE CITY APPROVED PLANS. TREES ARE TO BE FERTILIZED VIA SOIL INJECTION METHOD (MINIMUM 100 PSI) USING DOGGETT X-L INJECTO 32-7-7 OR EQUIVALENT AT RECOMMENDED RATES. CONSTRUCTION THAT WILL BE COMPLETE IN LESS THAN 90 DAYS SHOULD USE MATERIAL AT RECOMMENDED RATES. ALTERNATIVE ORGANIC FERTILIZER MATERIALS ARE ACCEPTABLE WHEN APPROVED BY THE CITY ARBORIST.

SITE DEVELOPMENT PERMIT - IRRIGATION NOTES

DOOR.

- 1. THE IRRIGATION SYSTEM SHALL BE DESIGNED AND INSTALLED SO THAT:
- (a) THERE IS NOT DIRECT OVERSPRAY ONTO NON-IRRIGATION AREAS;
- (b) THE SYSTEM DOES NOT INCLUDE SPRAY IRRIGATION ON AREAS LESS THAN FOUR (4) FEET WIDE (SUCH AS MEDIANS. BUFFER STRIPS, AND PARKING LOT ISLANDS)
- (c) ABOVE GROUND IRRIGATION EMISSION DEVICES ARE SET BACK AT LEAST FOUR (4) INCHES FROM IMPERVIOUS SURFACES:
- (d) THE IRRIGATION SYSTEM HAS A MASTER VALVE LOCATED DOWNSTREAM OF THE BACKFLOW PREVENTION DEVICE: (e) CIRCUIT REMOTE CONTROL VALVES ARE ADJACENT TO PAVED AREAS WHERE ELEVATION DIFFERENCES MAY CAUSE LOW
- DEAD DRAINAGE: (f) SERVICEABLE IN-HEAD CHECK VALVES ARE ADJACENT TO PAVED AREAS WHERE ELEVATION DIFFERENCES MAY CAUSE
- LOW HEAD DRAINAGE (g) THE IRRIGATION SYSTEM HAS A WEATHER BASED CONTROLLER;
- (h) AN AUTOMATIC RAIN SENSOR DEVICE SHUTS OFF THE IRRIGATION SYSTEM AUTOMATICALLY AFTER NOT MORE THAN A ONE-HALF INCH (1/2")RAINFALL
- (i) ZONE VALVES AND CIRCUITS ARE SEPARATED BASED ON PLANT WATER REQUIREMENTS AND IRRIGATE AT THE SAME PRECIPITATION RATE: (j) AN IRRIGATION EMISSION DEVICE (SUCH AS SPRAY, ROTOR, OR DRIP EMITTER) DOES NOT EXCEED THE MANUFACTURER'S RECOMMENDED OPERATING PRESSURE; AND
- (k) NO COMPONENT OF THE IRRIGATION SYSTEM DEVIATED FROM THE MANUFACTURER'S RECOMMENDED USE OF THE PRODUCT. 2. ALL NEW IRRIGATION SYSTEMS SHALL INCLUDE AN IDOLATION VALVE LOCATED BETWEEN THE METER AND THE BACKFLOW
- PREVENTION DEVICE ALL SPRAY HEADS SHALL PROVIDE HEAD TO HEAD COVERAGE; SPACING OF HEADS SHALL NOT EXCEED THE RADIUS OF THROW OF THE HEAD AS DETERMINED BY THE MANUFACTURER.
- 4. THE IRRIGATION INSTALLER SHALL DEVELOP AND PROVIDE AN AS-BUILT DESIGN PLAN, THE MANUFACTURER'S MANUAL FOR THE AUTOMATIC CONTROLLER, A SEASONAL WATERING SCHEDULE, AND WATER BUDGET TO THE CITY AT THE TIME THE FINAL PLUMBING INSPECTION IS PERFORMED. THE WATER BUDGET SHALL INCLUDE:
- (a) A CHART CONTAINING ZONE NUMBERS, PRECIPITATION RATE, AND GALLONS PER MINUTE; AND
- (b) THE LOCATION OF THE EMERGENCY IRRIGATIONS SYSTEM SHUT-OFF VALVE a LAMINATED COPY OF WATER BUDGET SHALL BE PERMANENTLY INSTALLED INSIDE THE IRRIGATION CONTROLLER

SCALE: 1-1/2" = 1'-0'

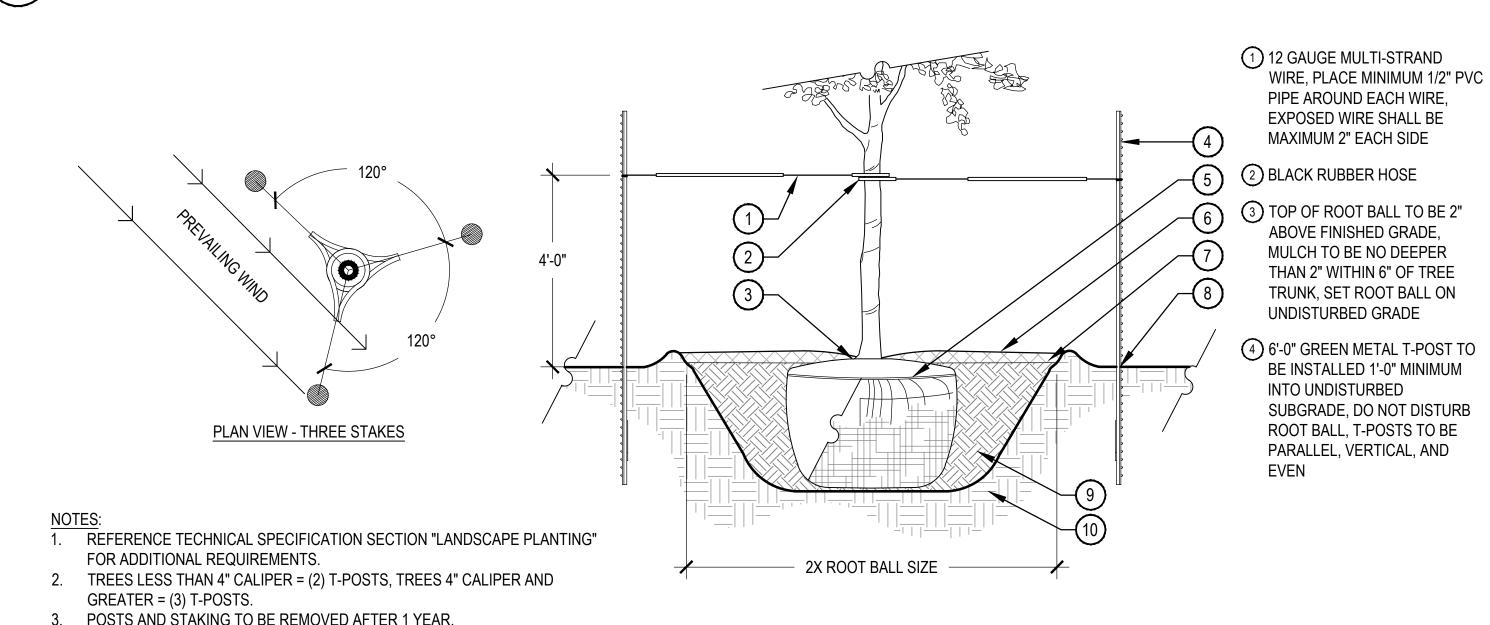

(5) CUT ALL ROPES, WIRES, AND BURLAP FROM TRUNK AND TOP OF ROOT BALL, REMOVE ALL **CONTAINERS FROM ROOT BALL**

(6) 3" LAYER OF SPECIFIED MULCH

(7) 5" HIGH EARTHEN WATER

RETENTION BASIN

(8) FINISH GRADE

9 SPECIFIED SOIL BACKFILL MIX

10 UNDISTURBED SUBGRADE

SHEET TITLE: LANDSCAPE CALCULATIONS AND NOTES SHEET NUMBER:

OWNER:

ERICKSON LIVING

CHRIS TURNBUL

701 MAIDEN CHOICE LANE

CATONSVILLE, MD 21228

(410)-242-2880

February 9, 2023

DATE:

10/06/22 PERMIT

1\02/09/23 REV.01

NORRIS DESIGN

Planning | Landscape Architecture | Branding

208 North Market Street

www.norris-design.com

10

Suite 250

Dallas, TX 75202

972.232.4169

TREE PLANTING DETAIL

TREE SURVEY HAS NOT BEEN VERIFIED BY AN ARBORIST. CALIPER AND SPECIES TO BE FIELD

VERIFIED PRIOR TO FINAL MITIGATION CALCULATIONS.

CHECKE DRAWN I FILENAM

SCALE: 1/2" = 1'-0"